

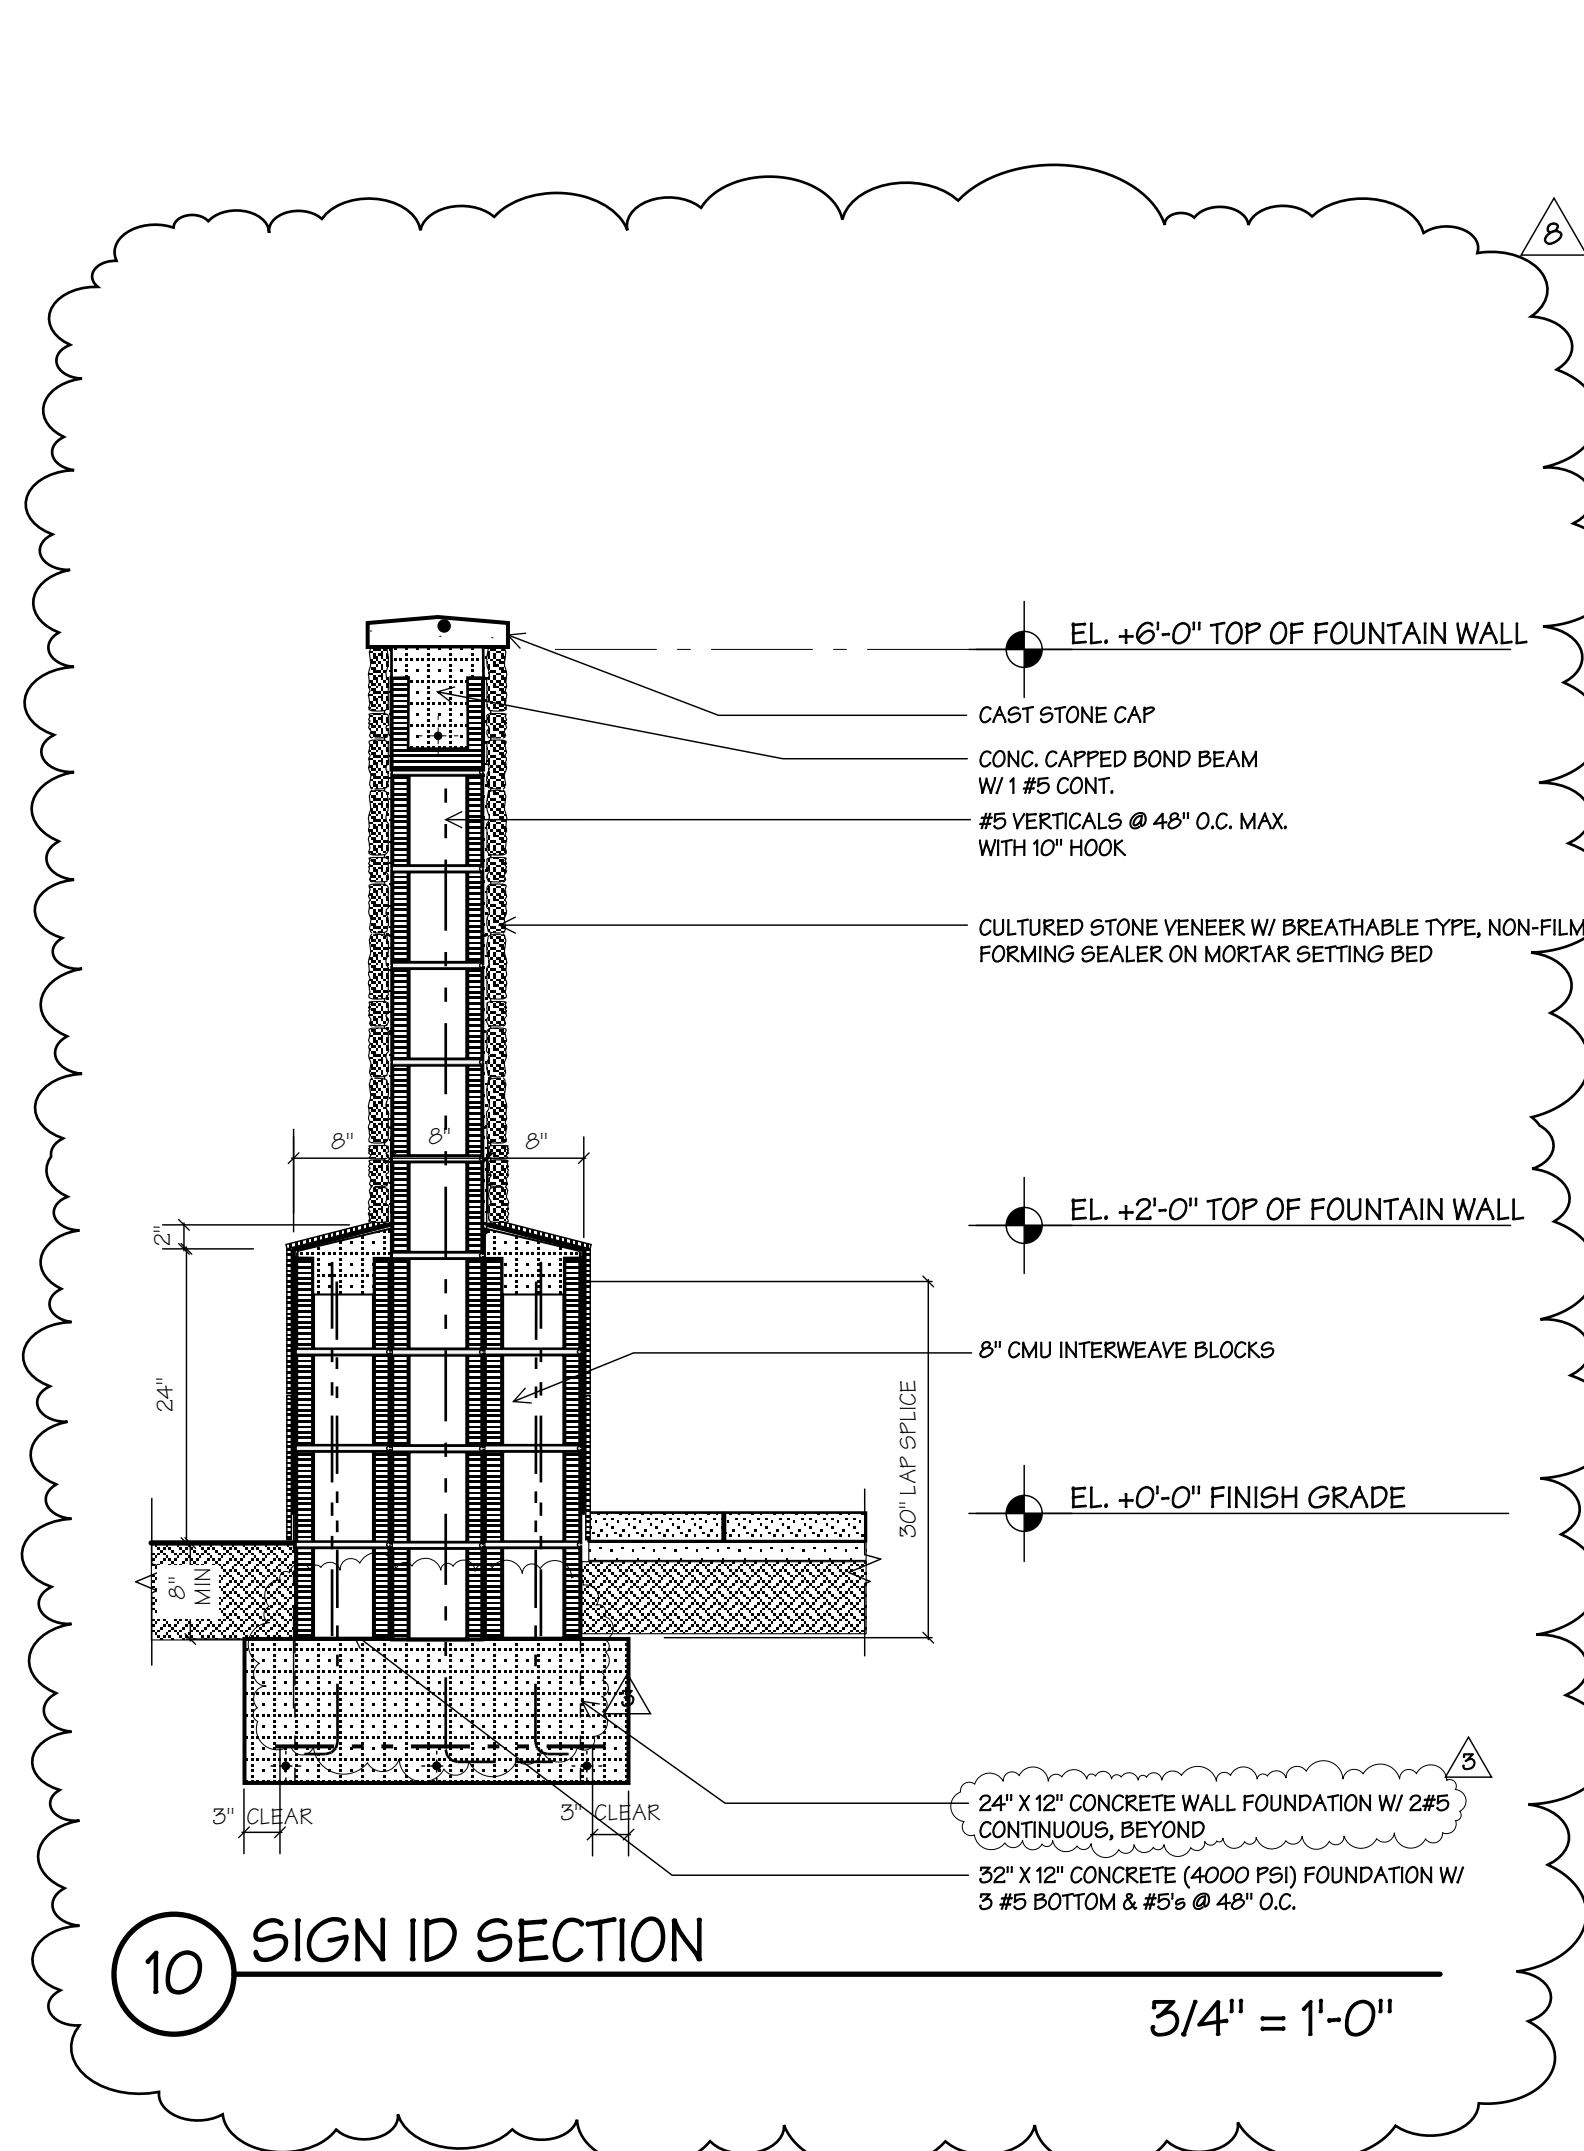
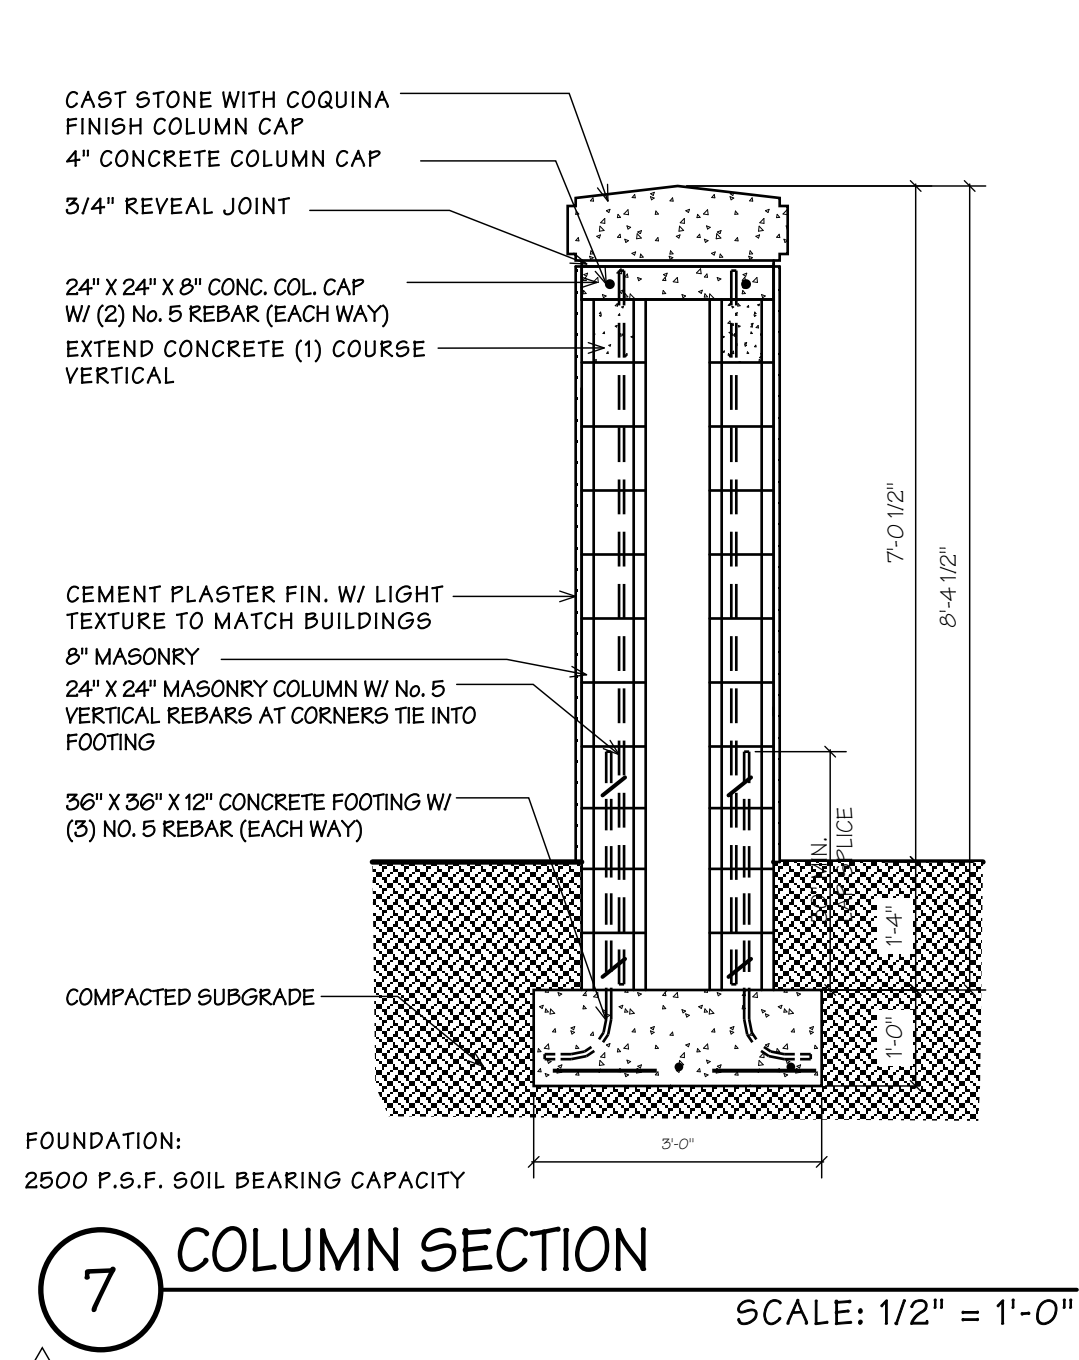
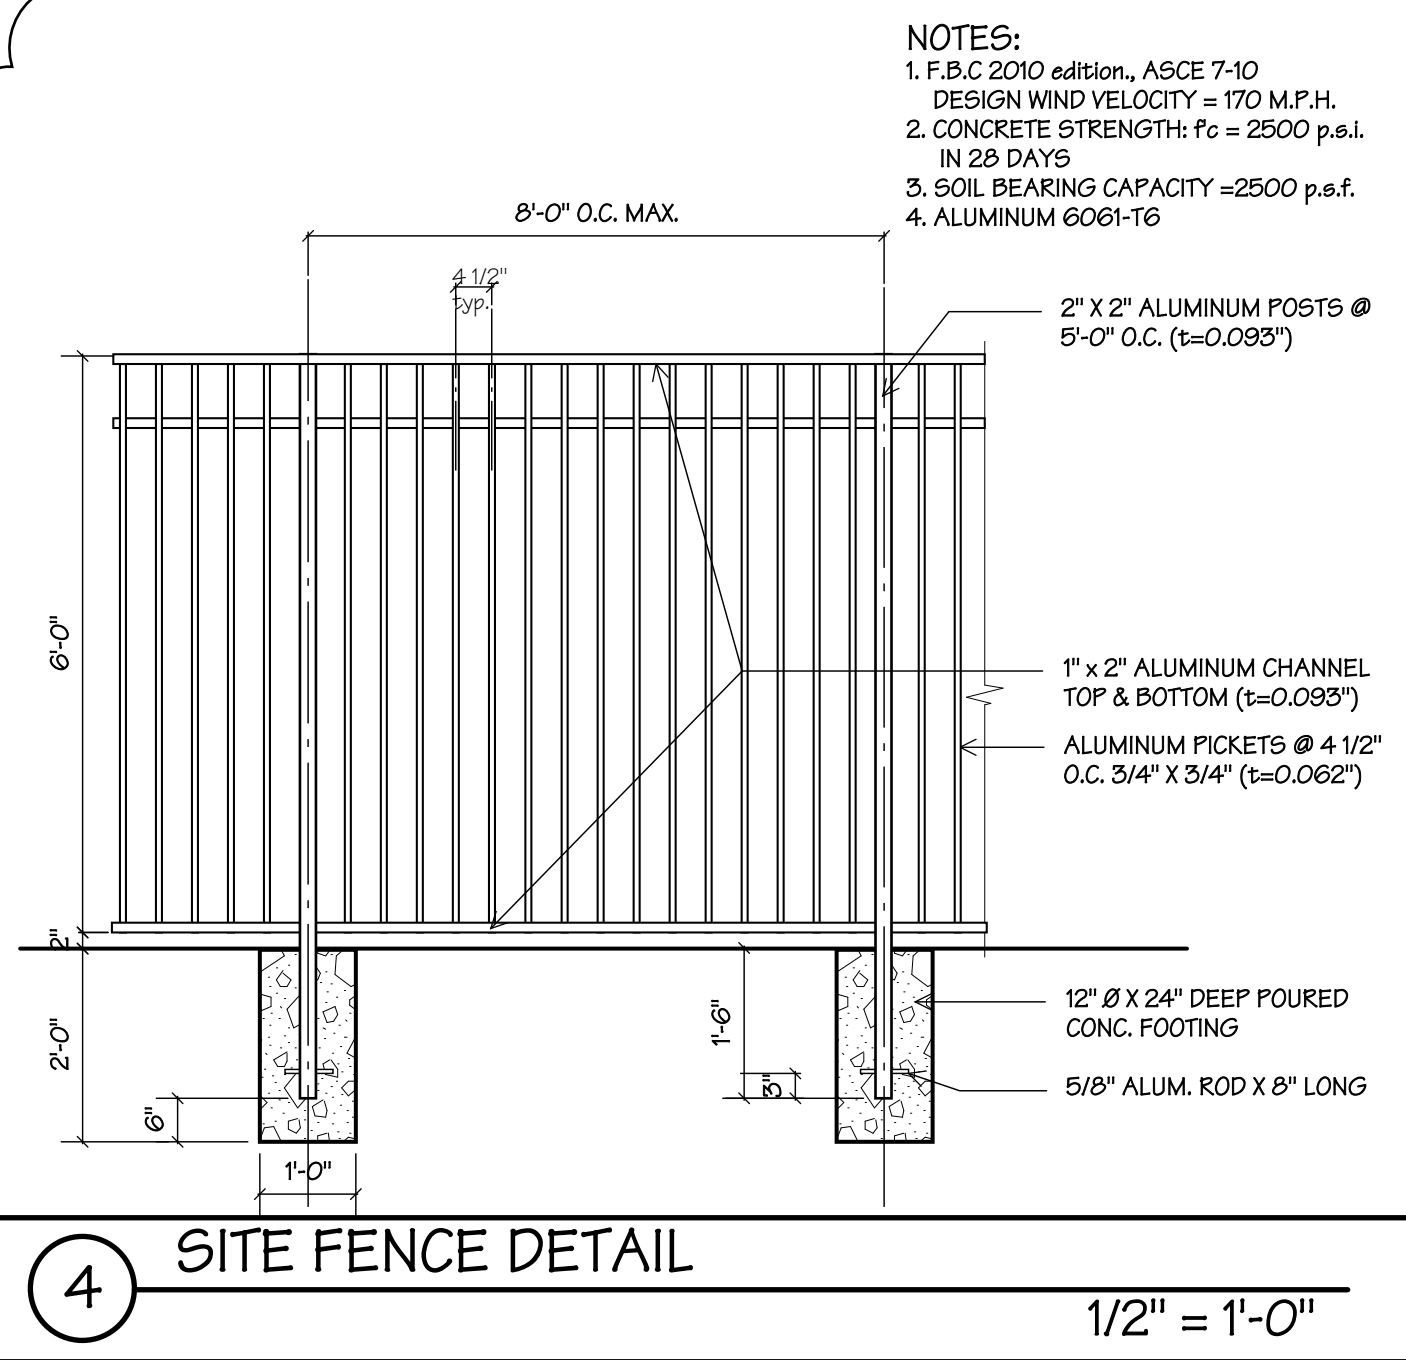
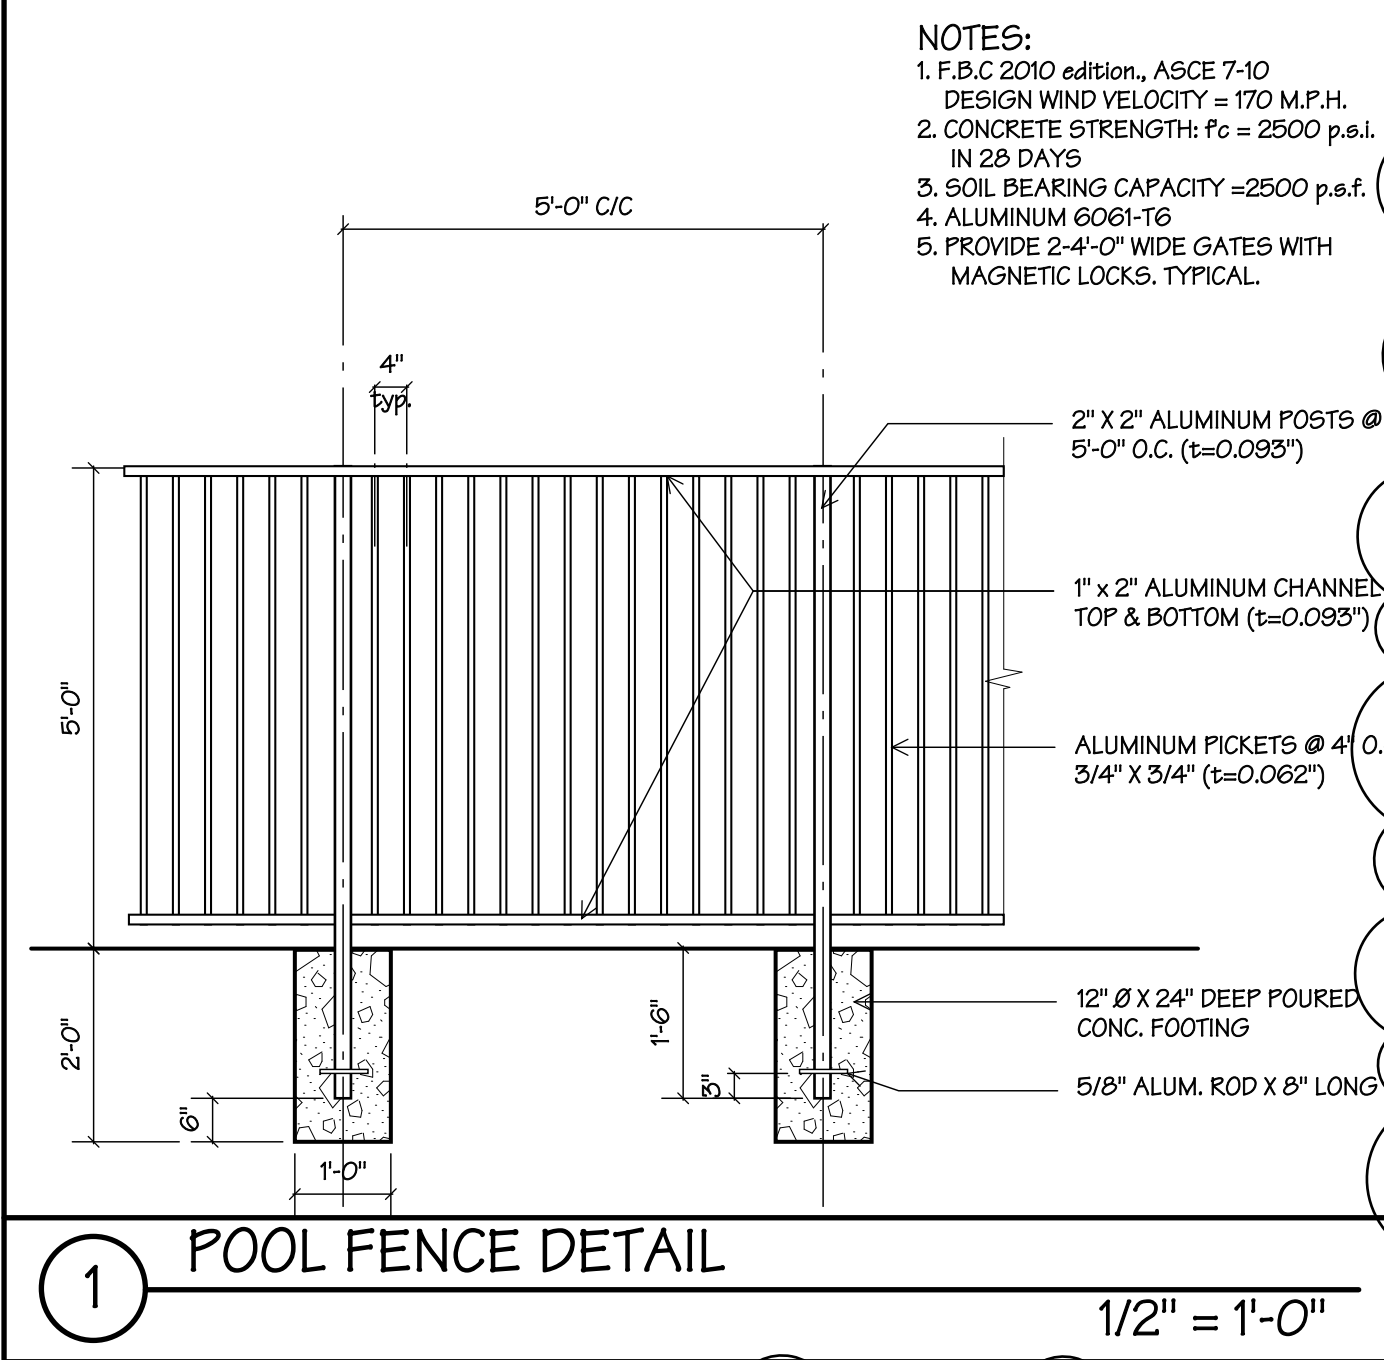
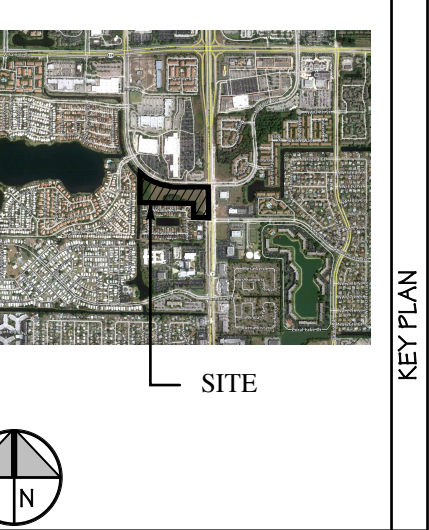
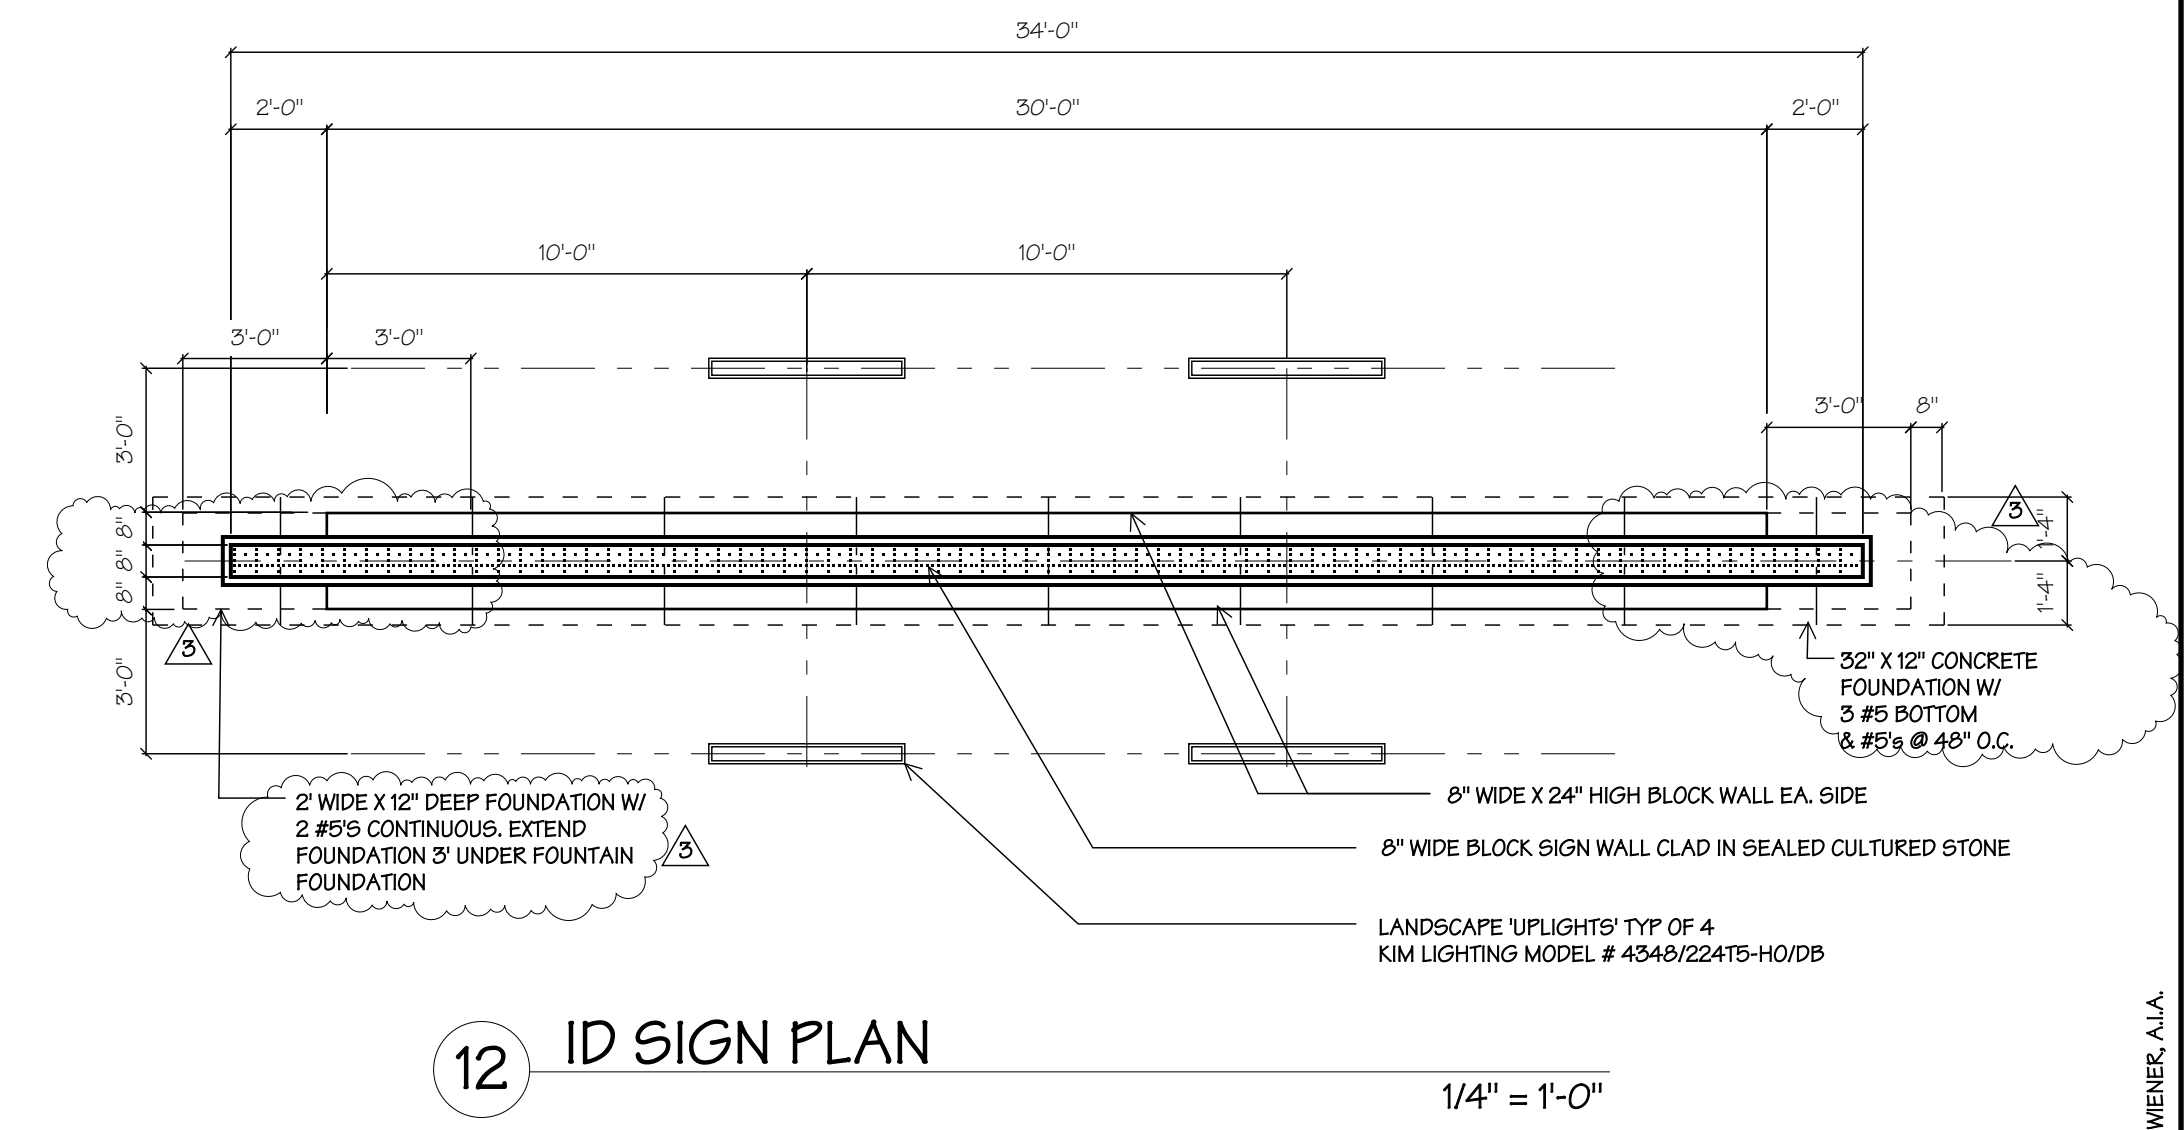
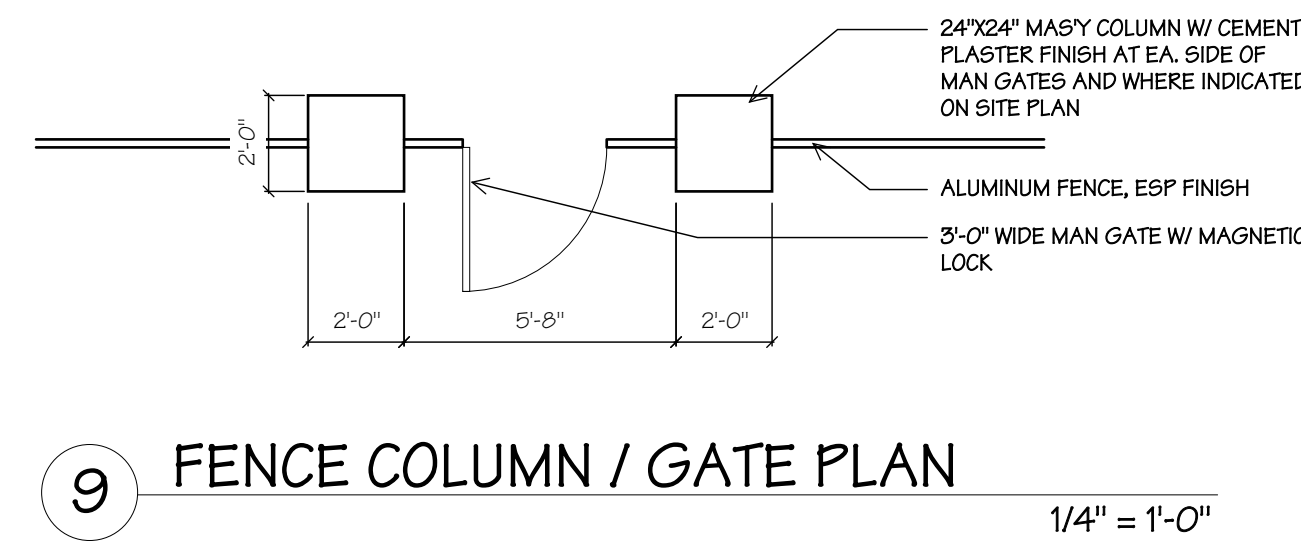


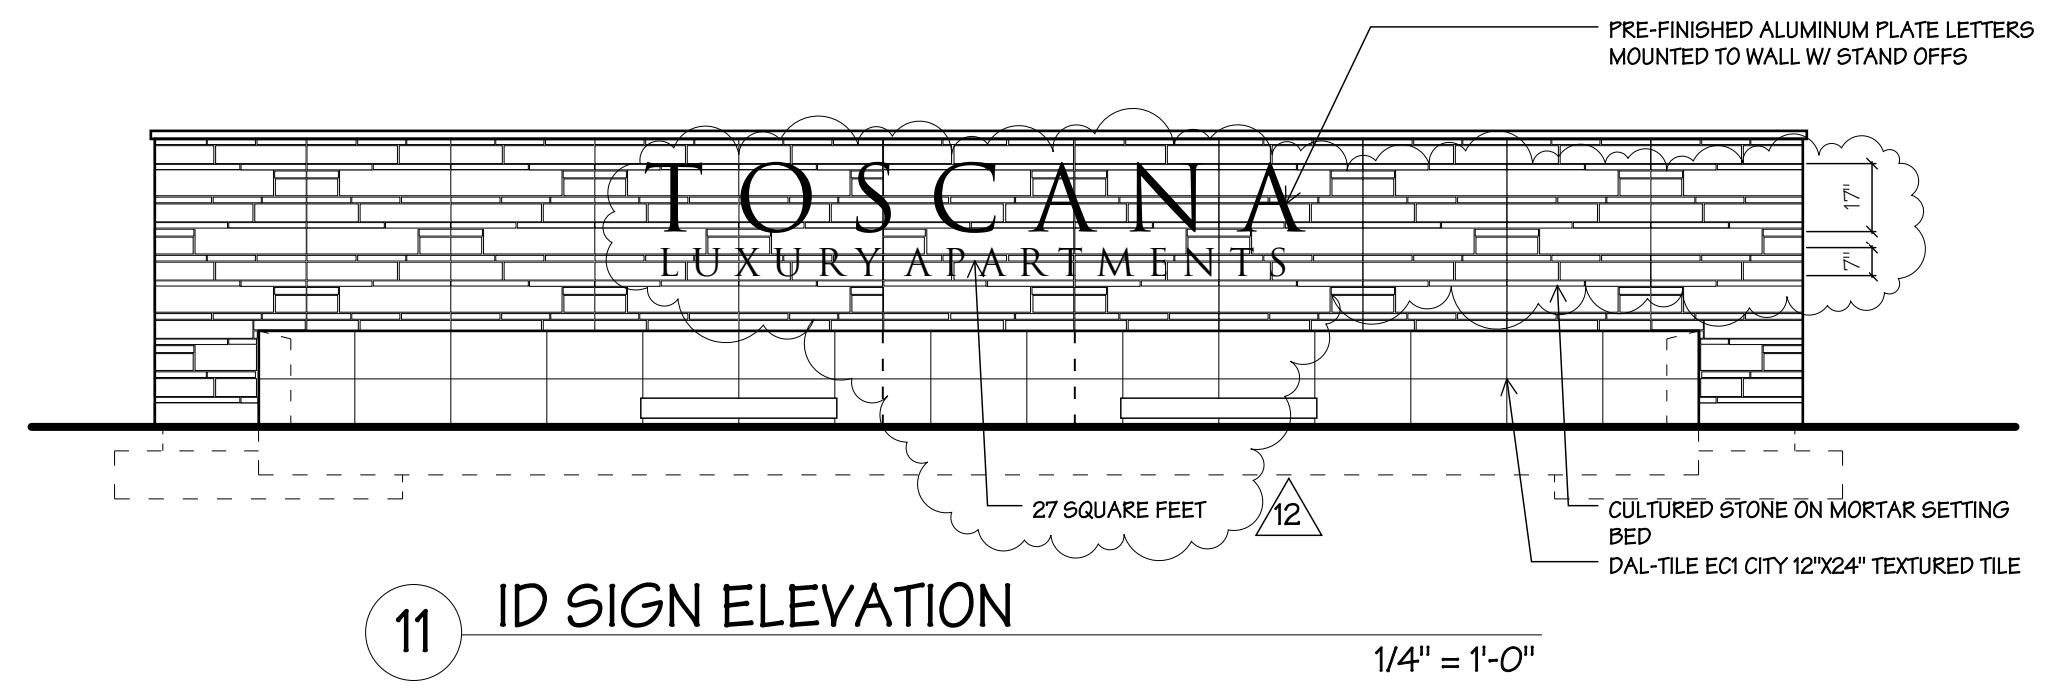

2 NOT USED

1/2" = 1'-0"

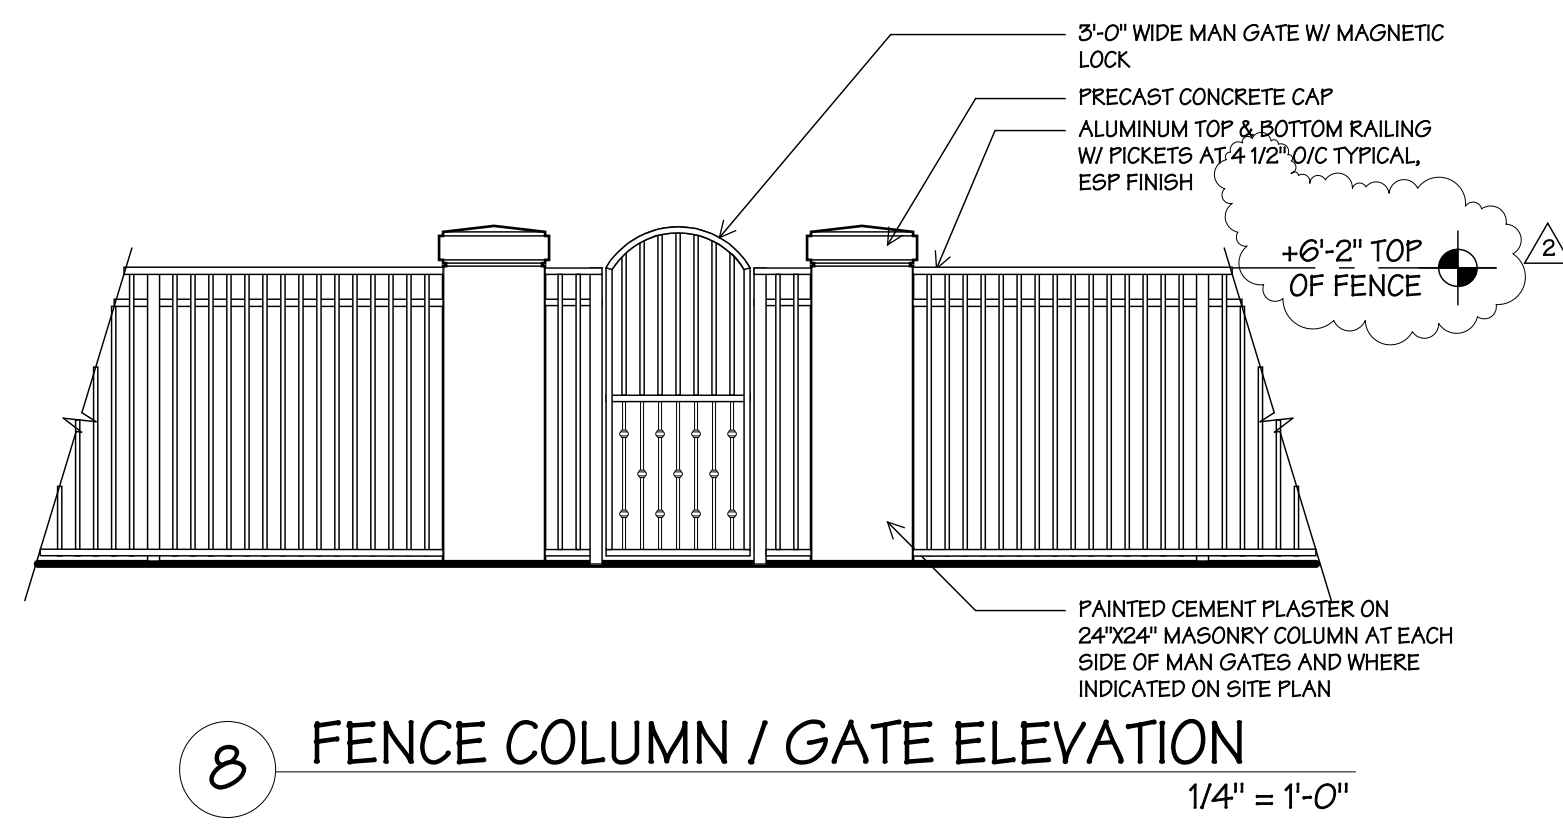

MARK	DESCRIPTION	DATE
△	BD PRELIM REVIEW	6/20/14
△	DRC COMMENTS	8/15/14
△	BD COMMENTS	9/24/14
△	OWNER CHANGE	10/31/14
△	BLDG #1 (TYPE III.3)	12/1/14
△	ADD UNIT NO.'S	12/22/14
△	COORDINATION	01/14/15
△	REVISE SIGNWALL	01/27/15
△	TYPE II SPR. RISER REV.	3/2/15
△	RADON	3/13/15
△	TYPE II ELEC RM	4/15/15
△	AS-BUILT CHANGES	

MARC WIENER, AIA
ARCHITECTURE/PLANNING
AR # 000446
23 SE. 4th STREET, SUITE 101
BOCA RATON, FLORIDA 33432
561-750-4111 FAX 561-750-5299

STATE OF FLORIDA
MARC WIENER
10416
REGISTERED ARCHITECT
OCT 12, 2015

Florida Crystals
Investment Corporation
One North Clematis Street
Suite 200
West Palm Beach, FL 33401

ATLANTICO TOSCANA APARTMENTS

MARGATE, FLORIDA

JOB NUMBER	13131
SCALE	AS NOTED
ISSUE DATE	OCT. 12, 2015
PERMIT DATE	JUNE 20, 2014
BID DATE	JUNE 20, 2014

DRAWN BY	LPK
CHECKED BY	MW
DISCIPLINE	ARCHITECTURE
PLAN TYPE	ID SIGN / FOUNTAIN
SHEET NUMBER	A1.03