

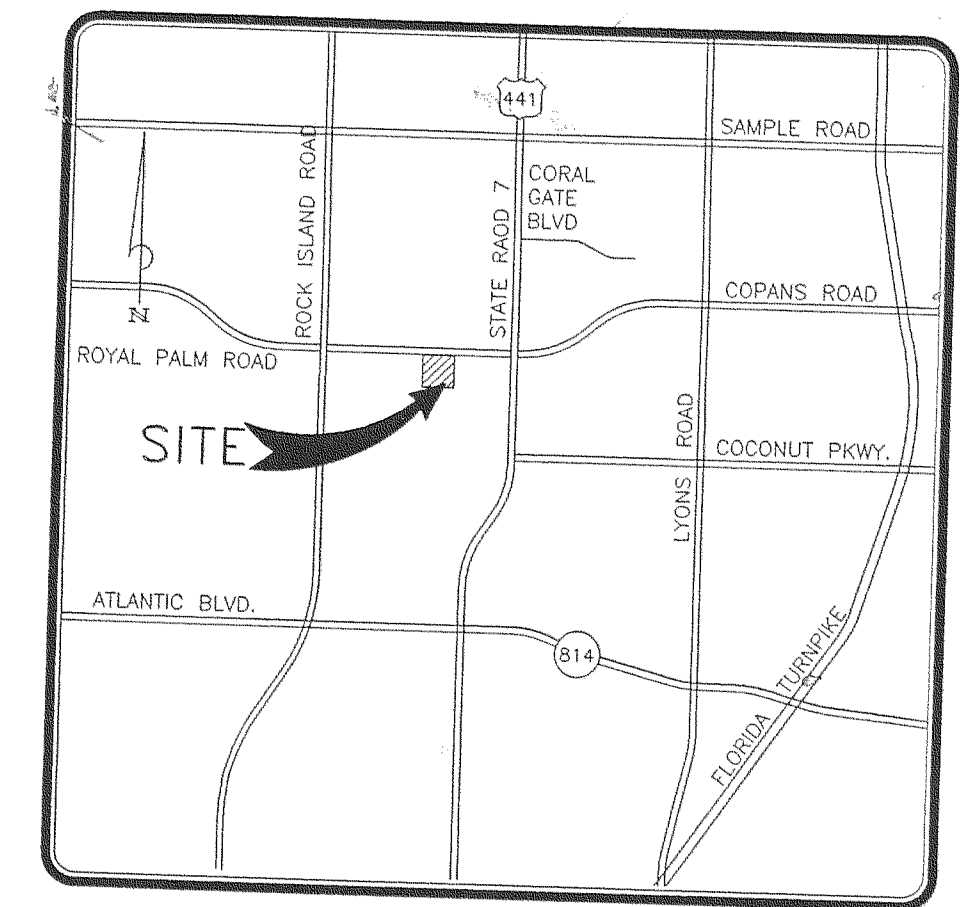
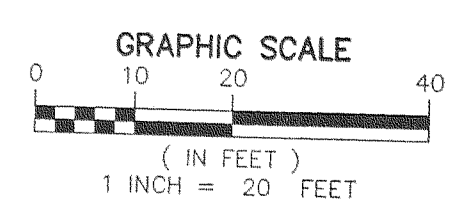


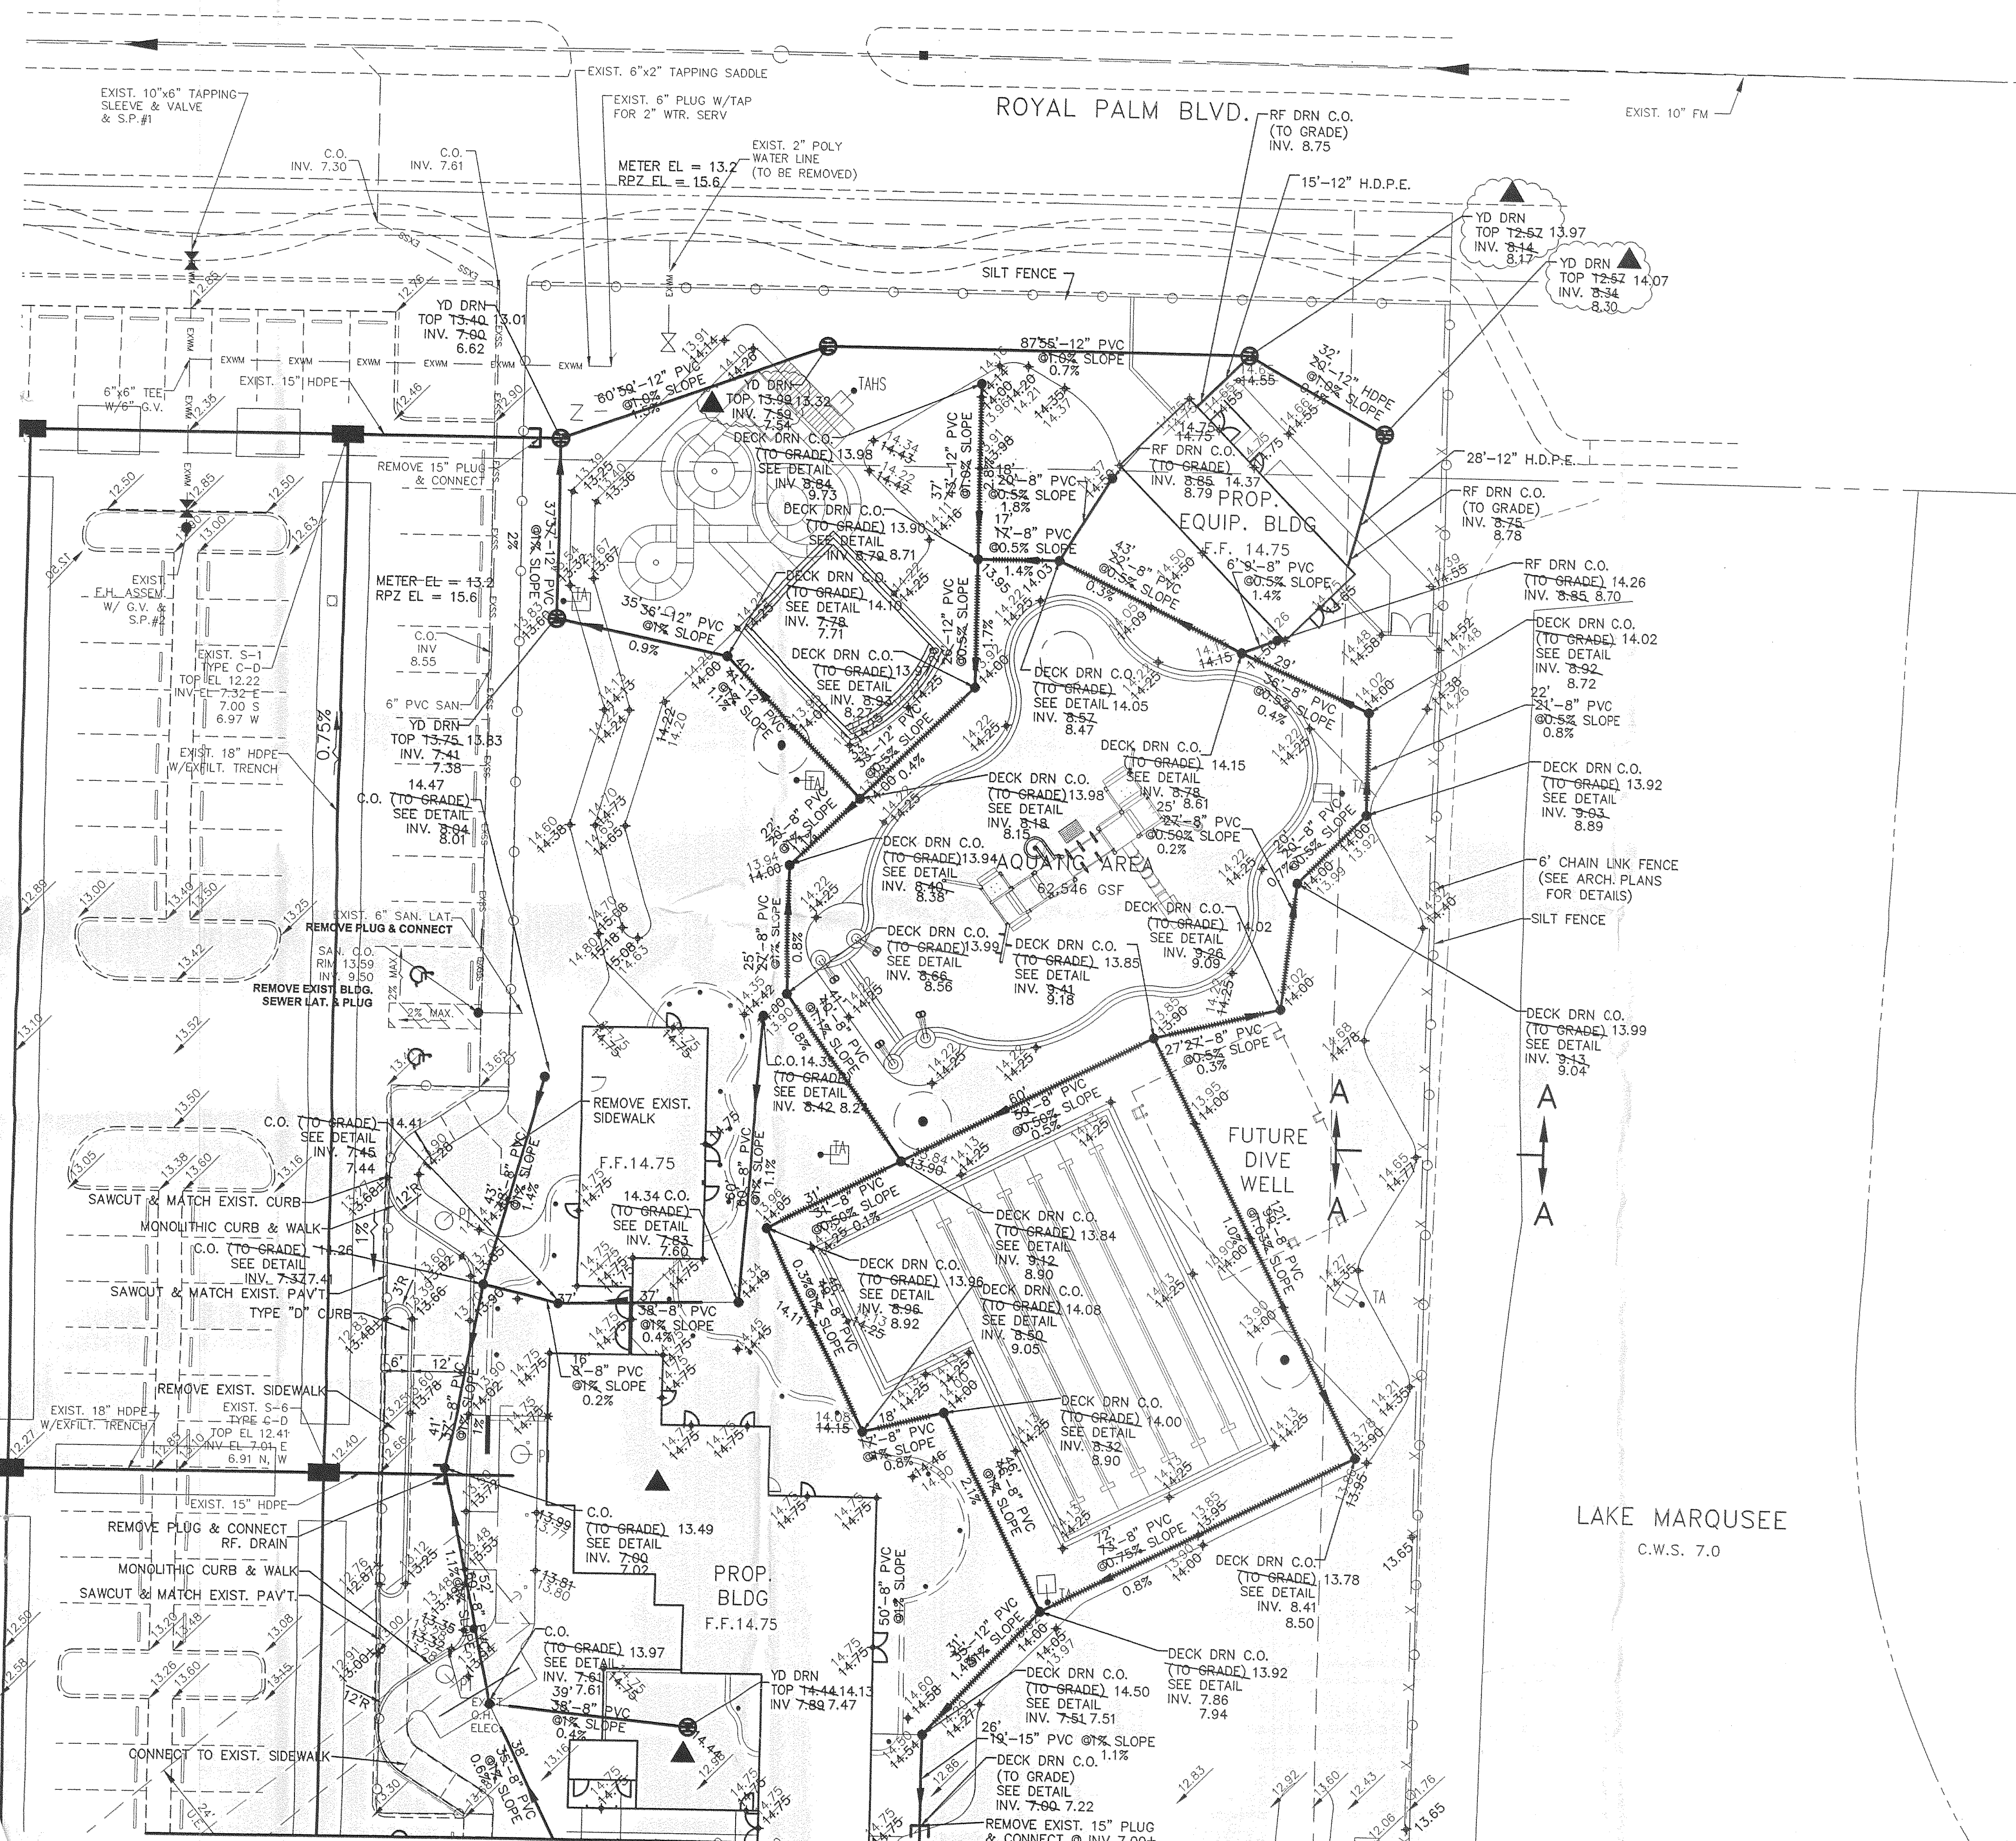

SECTION 25, TOWNSHIP 48 S, RANGE 41 E
LOCATION MAP
N.T.S.

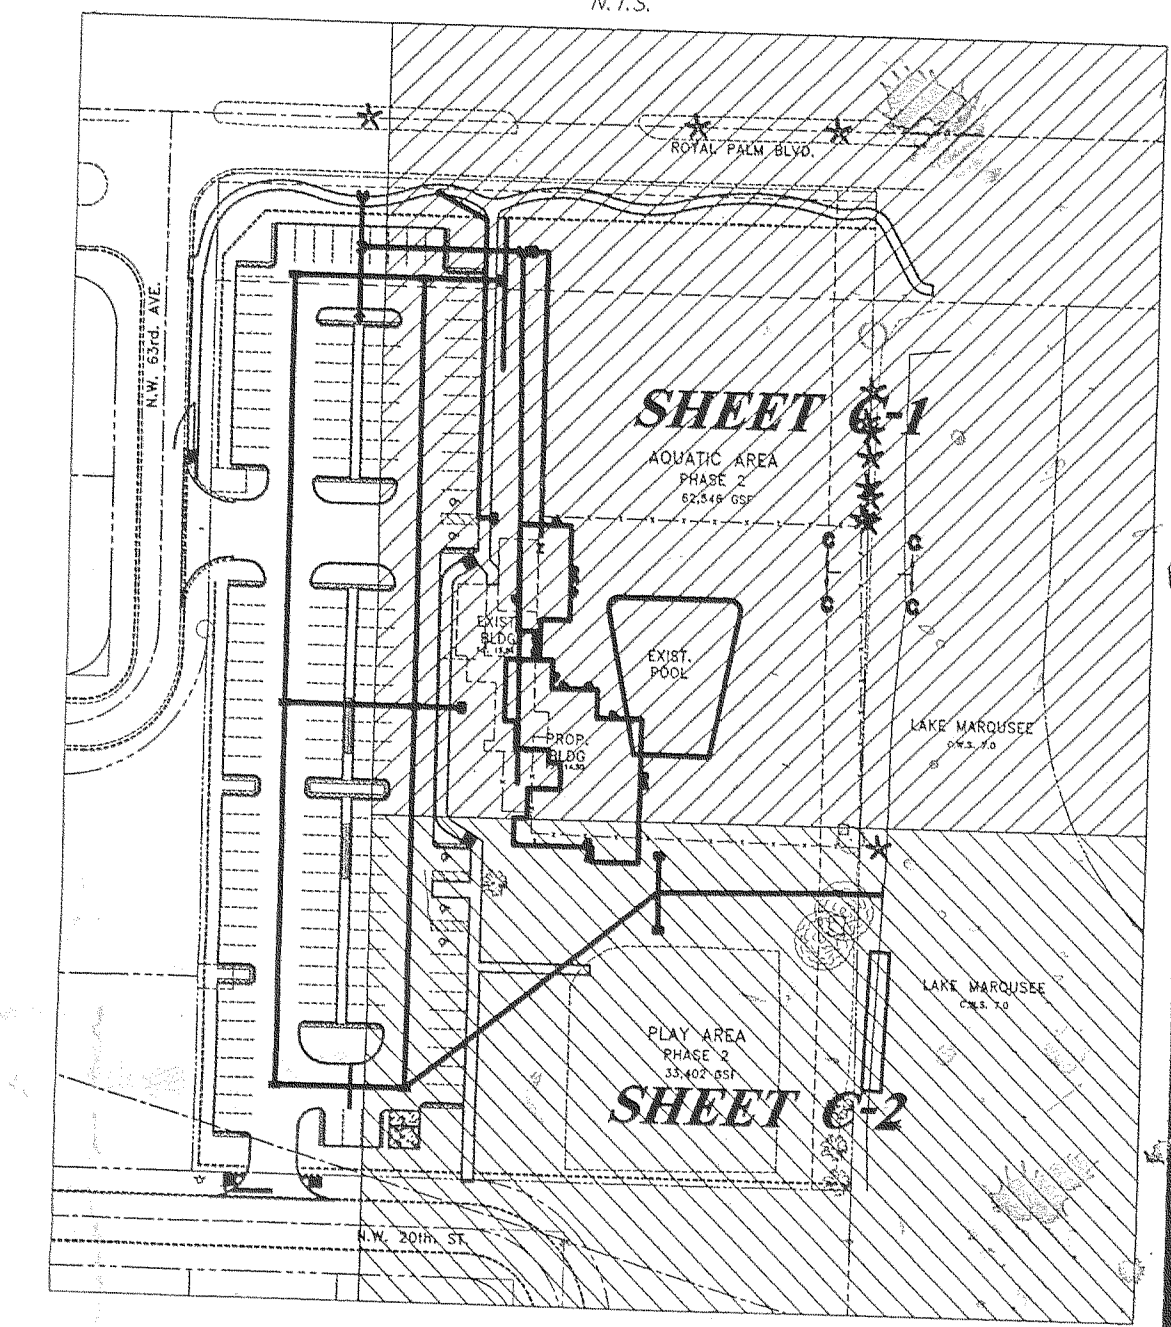

LEGEND

—	PROPOSED CHANNEL DECK DRAIN W/PVC PIPE (SIZE INDICATED ON PLAN)	—	PROPOSED GRADE
—	PROPOSED WATER PIPE	—	EXISTING ELEVATION
—	PROPOSED SANITARY SEWER PIPE	—	PROPOSED ASPHALT
—	PROPOSED PIPE FLOW DIRECTION	—	PROPOSED CONCRETE
⊙	PROPOSED YARD DRAIN	—	TACTILE SURFACE
•	PROPOSED DECK DRAIN	⊙	PROPOSED SHOWER - SEE ARCHITECTURAL PLANS FOR DETAILS
—	PROPOSED HOSE BIBB EVERY 50 FEET ALONG WATER SERVICE - PROVIDE J.R. SMITH 5730-NB BOX W/12"x12"x4" CONCRETE THRUST BLOCK.	⊙	PROPOSED SAMPLE POINT

NOTE:

- CONTRACTOR SHALL UTILIZE 45', 22-1/2', 11-1/4' BENDS AS REQUIRED.
- CONTRACTOR TO MAINTAIN MINIMUM 2% TO MAXIMUM 4% SLOPE BETWEEN DECK DRAIN AND POOL EDGE.

EXISTING UTILITY NOTES:

- CONTRACTOR TO VERIFY LOCATION OF ALL EXISTING UTILITIES.
- IT SHALL BE THE CONTRACTOR'S SOLE RESPONSIBILITY TO TAKE THE NECESSARY PRECAUTIONS TO ENSURE PROPER SAFETY AND WORKMANSHIP WHEN WORKING IN THE VICINITY OF EXISTING UTILITY LINES.
- CONTRACTOR SHALL BE RESPONSIBLE TO COORDINATE WITH FPL ON ANY WORK IN THE VICINITY OF OVERHEAD OR UNDERGROUND POWER LINES.
- CONTRACTOR SHALL VERIFY PROPER CLEARANCE BELOW EXISTING OVERHEAD POWER LINES PRIOR TO WORKING WITHIN THE VICINITY THE POWER LINES.

STANDARD WATER AND SEWER SEPARATION STATEMENT

A) NEW OR RELOCATED, UNDERGROUND WATER MAINS INCLUDED IN THIS PROJECT WILL BE LAID TO PROVIDE A HORIZONTAL DISTANCE OF AT LEAST THREE FEET BETWEEN THE OUTSIDE OF THE WATER MAIN AND THE OUTSIDE OF ANY EXISTING OR PROPOSED VACUUM TYPE SANITARY SEWER, STORM SEWER, STORMWATER FORCE MAIN, OR PIPELINE CONVEYING RECLAIMED WATER REGULATED UNDER PART III OF CHAPTER 62-610, F.A.C.

B) NEW OR RELOCATED, UNDERGROUND WATER MAINS THAT ARE INCLUDED IN THIS PROJECT AND THAT WILL CROSS ANY EXISTING OR PROPOSED GRAVITY- OR VACUUM- TYPE SANITARY SEWER OR STORM SEWER WILL BE LAID SO THE OUTSIDE OF THE WATER MAIN JOINTS WILL BE AT LEAST 6 INCHES ABOVE THE OTHER PIPELINE OR AT LEAST 12 INCHES BELOW THE OTHER PIPELINE. AND NEW OR RELOCATED, UNDERGROUND WATER MAINS THAT ARE INCLUDED IN THIS PROJECT AND THAT WILL CROSS ANY EXISTING OR PROPOSED PRESSURE- TYPE SANITARY SEWER, WASTEWATER OR STORMWATER FORCE MAIN, OR PIPELINE CONVEYING RECLAIMED WATER WILL BE LAID SO THE OUTSIDE OF THE WATER MAIN IS AT LEAST 12 INCHES ABOVE OR BELOW THE OTHER PIPELINE.

C) AT THE UTILITY CROSSING DESCRIBED IN PART A ABOVE, ONE FULL LENGTH OF WATER MAIN PIPE WILL BE CENTERED ABOVE OR BELOW THE OTHER PIPELINE SO THE WATER MAIN JOINTS WILL BE AS FAR AS POSSIBLE FROM THE OTHER PIPELINE OR THE PIPES WILL BE ARRANGED SO THAT ALL WATER MAIN JOINTS ARE AT LEAST THREE FEET FROM ALL JOINTS IN VACUUM- TYPE SANITARY SEWERS, STORM SEWERS, STORMWATER FORCE MAINS, OR PIPELINES CONVEYING RECLAIMED WATER REGULATED UNDER PART III OF CHAPTER 62-610, F.A.C. AND ANY OTHER APPLICABLE REGULATIONS.

CERTIFICATE:
I HEREBY CERTIFY THAT THE AS CONSTRUCTED INFORMATION REFLECTED HEREON IS TRUE AND CORRECT TO THE BEST OF MY KNOWLEDGE AND BELIEF AND IS BASED ON FIELD DATA COLLECTED THROUGH 06-15-05.
RICHARD L. DAVIS
P.L.S. #2643
STATE OF FLORIDA
509 N.E. 28 DRIVE
WILTON MANORS, FL 33334
PHONE (561) 566-0038
REVISED PER COMMENTS 6-28-05

REFER TO DRAWING NO. C-2 FOR CONTINUATION



MPA ARCHITECTS, INC.
ARCHITECTS
PLANNERS
INTERIOR DESIGNERS
1801 CENTREPARK DR.
SUITE 175
WEST PALM BEACH
FL 33401
TEL (561) 683-7000
FAX (561) 478-3922
FL LIC AA-C000630

SEAL

Michael F. Schwartz, P.E.
Fla. Registration No. 56200

FLORIDA

CALYPSO COVE
AT ROYAL PALM PARK
ROYAL PALM ROAD
MARGATE, BROWARD COUNTY

Scale: 1" = 20'
Date: 12/12/03
Design By: MFS
Drawn By: SHB
Check By: MFS
FILE NUMBER
03-00013

REVISIONS

5/7/04	PERMIT
5/7/04	RESPONSE TO
5/7/04	REVISIONS

Prepared by:



Main Office:
100 N. Highway 1, Suite 200
Pembroke Pines, Florida 33024-3300
(854) 438-7000 Fax: (854) 438-6664
Palm Beach Regional Office:
1000 Corporate Center Way, Suite 200
West Palm Beach, Florida 33411-2500
(561) 798-9991 Fax: (561) 798-4008
Orlando Office:

SHEET

C-2